

CONTRA COSTA COUNTY
PUBLIC WORKS DEPARTMENT
**WILLOW LAKE ROAD SIDEWALK
GAP CLOSURE PHASE II**

PROJECT NO. 0662-6R4119-10

TO BE SUPPLEMENTED BY THE LATEST STATE STANDARD PLANS AND COUNTY STANDARD PLANS




PROJECT ENGINEER	20
C.E. 67557	
SENIOR PROJECT ENGINEER	20
C.E. 63539	
SUPERVISING PROJECT ENGINEER	20
APPROVED	20
BY: DEPUTY PUBLIC WORKS DIRECTOR	




1-800-227-2600

INDEX OF SHEETS

SHEET NO.	DESCRIPTION
1	TITLE SHEET
2	DETAILED LAYOUT

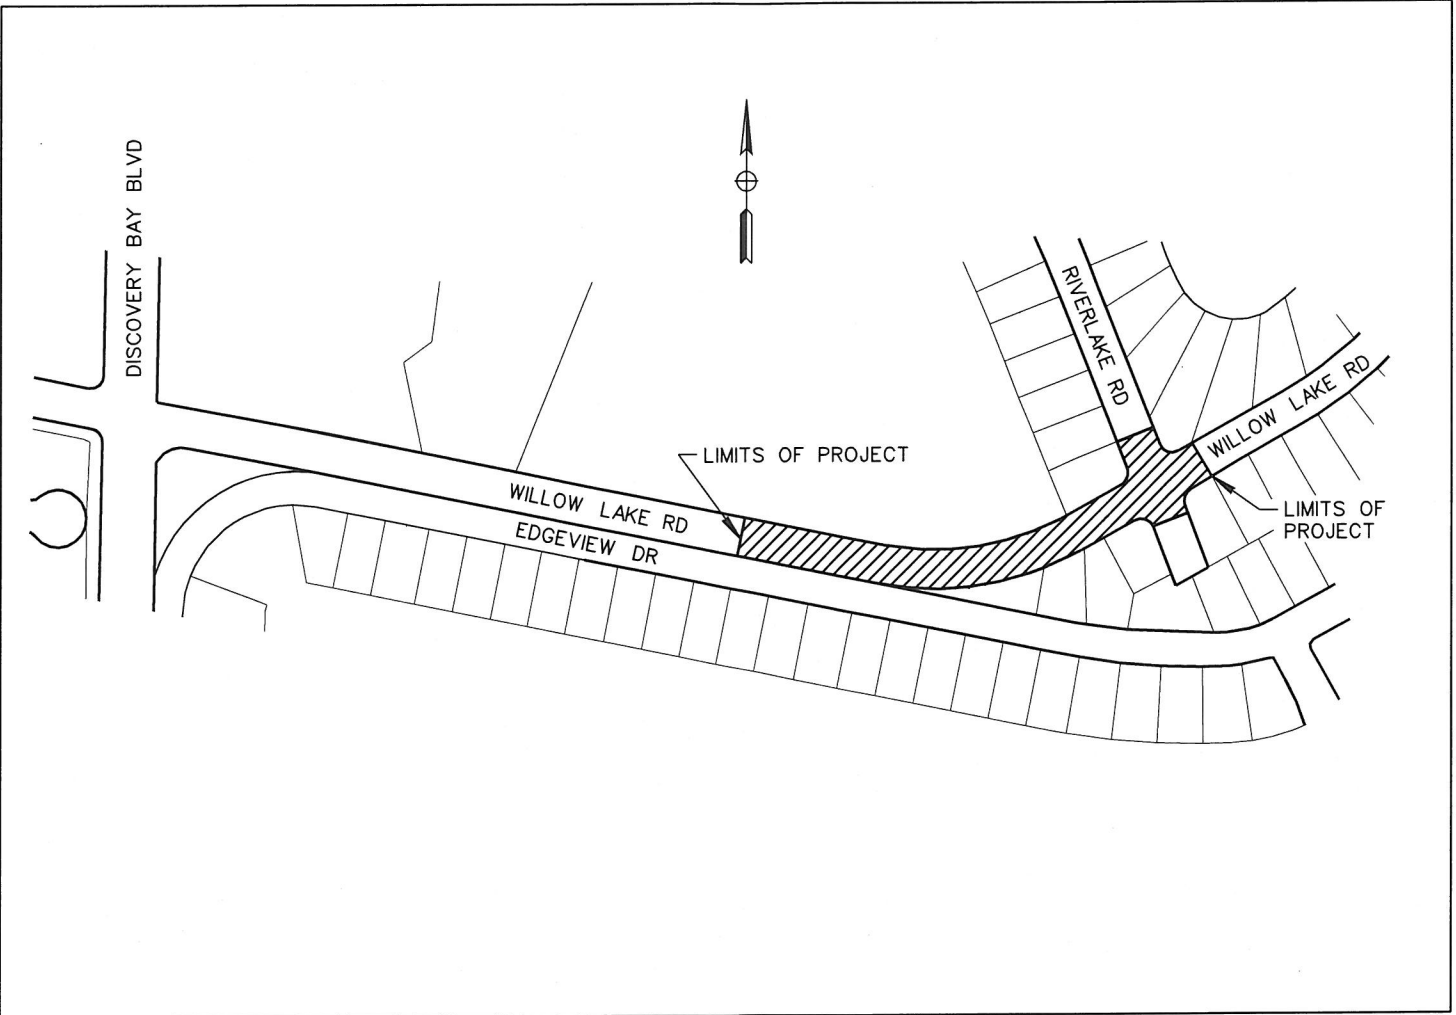

VICINITY MAP
NO SCALE

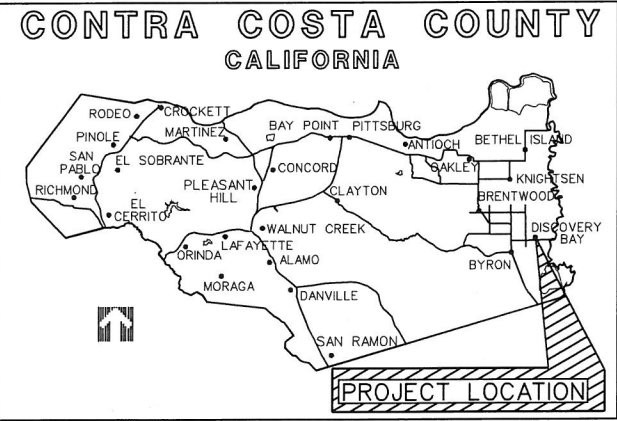


LOCATION MAP
NO SCALE

THE CONTRACTOR SHALL POSSESS THE CLASS (OR CLASSES)
OF LICENSE AS SPECIFIED IN THE "NOTICE TO CONTRACTORS".

CONTRACT NO. 0662-6R4119-10
DATE ACCEPTED 10-25-10
RECORD DRAWING
RESIDENT ENGINEER
REVISIONS BY L. COSTA DATE 11-18-10

BASE MAP	EAST COORD.	NORTH COORD.	FILE NO.	SHEET	OF
N28,N29	1683	512	SP-GC-2010	1	2
FILE NAME dc411910.001			PEN TBL		

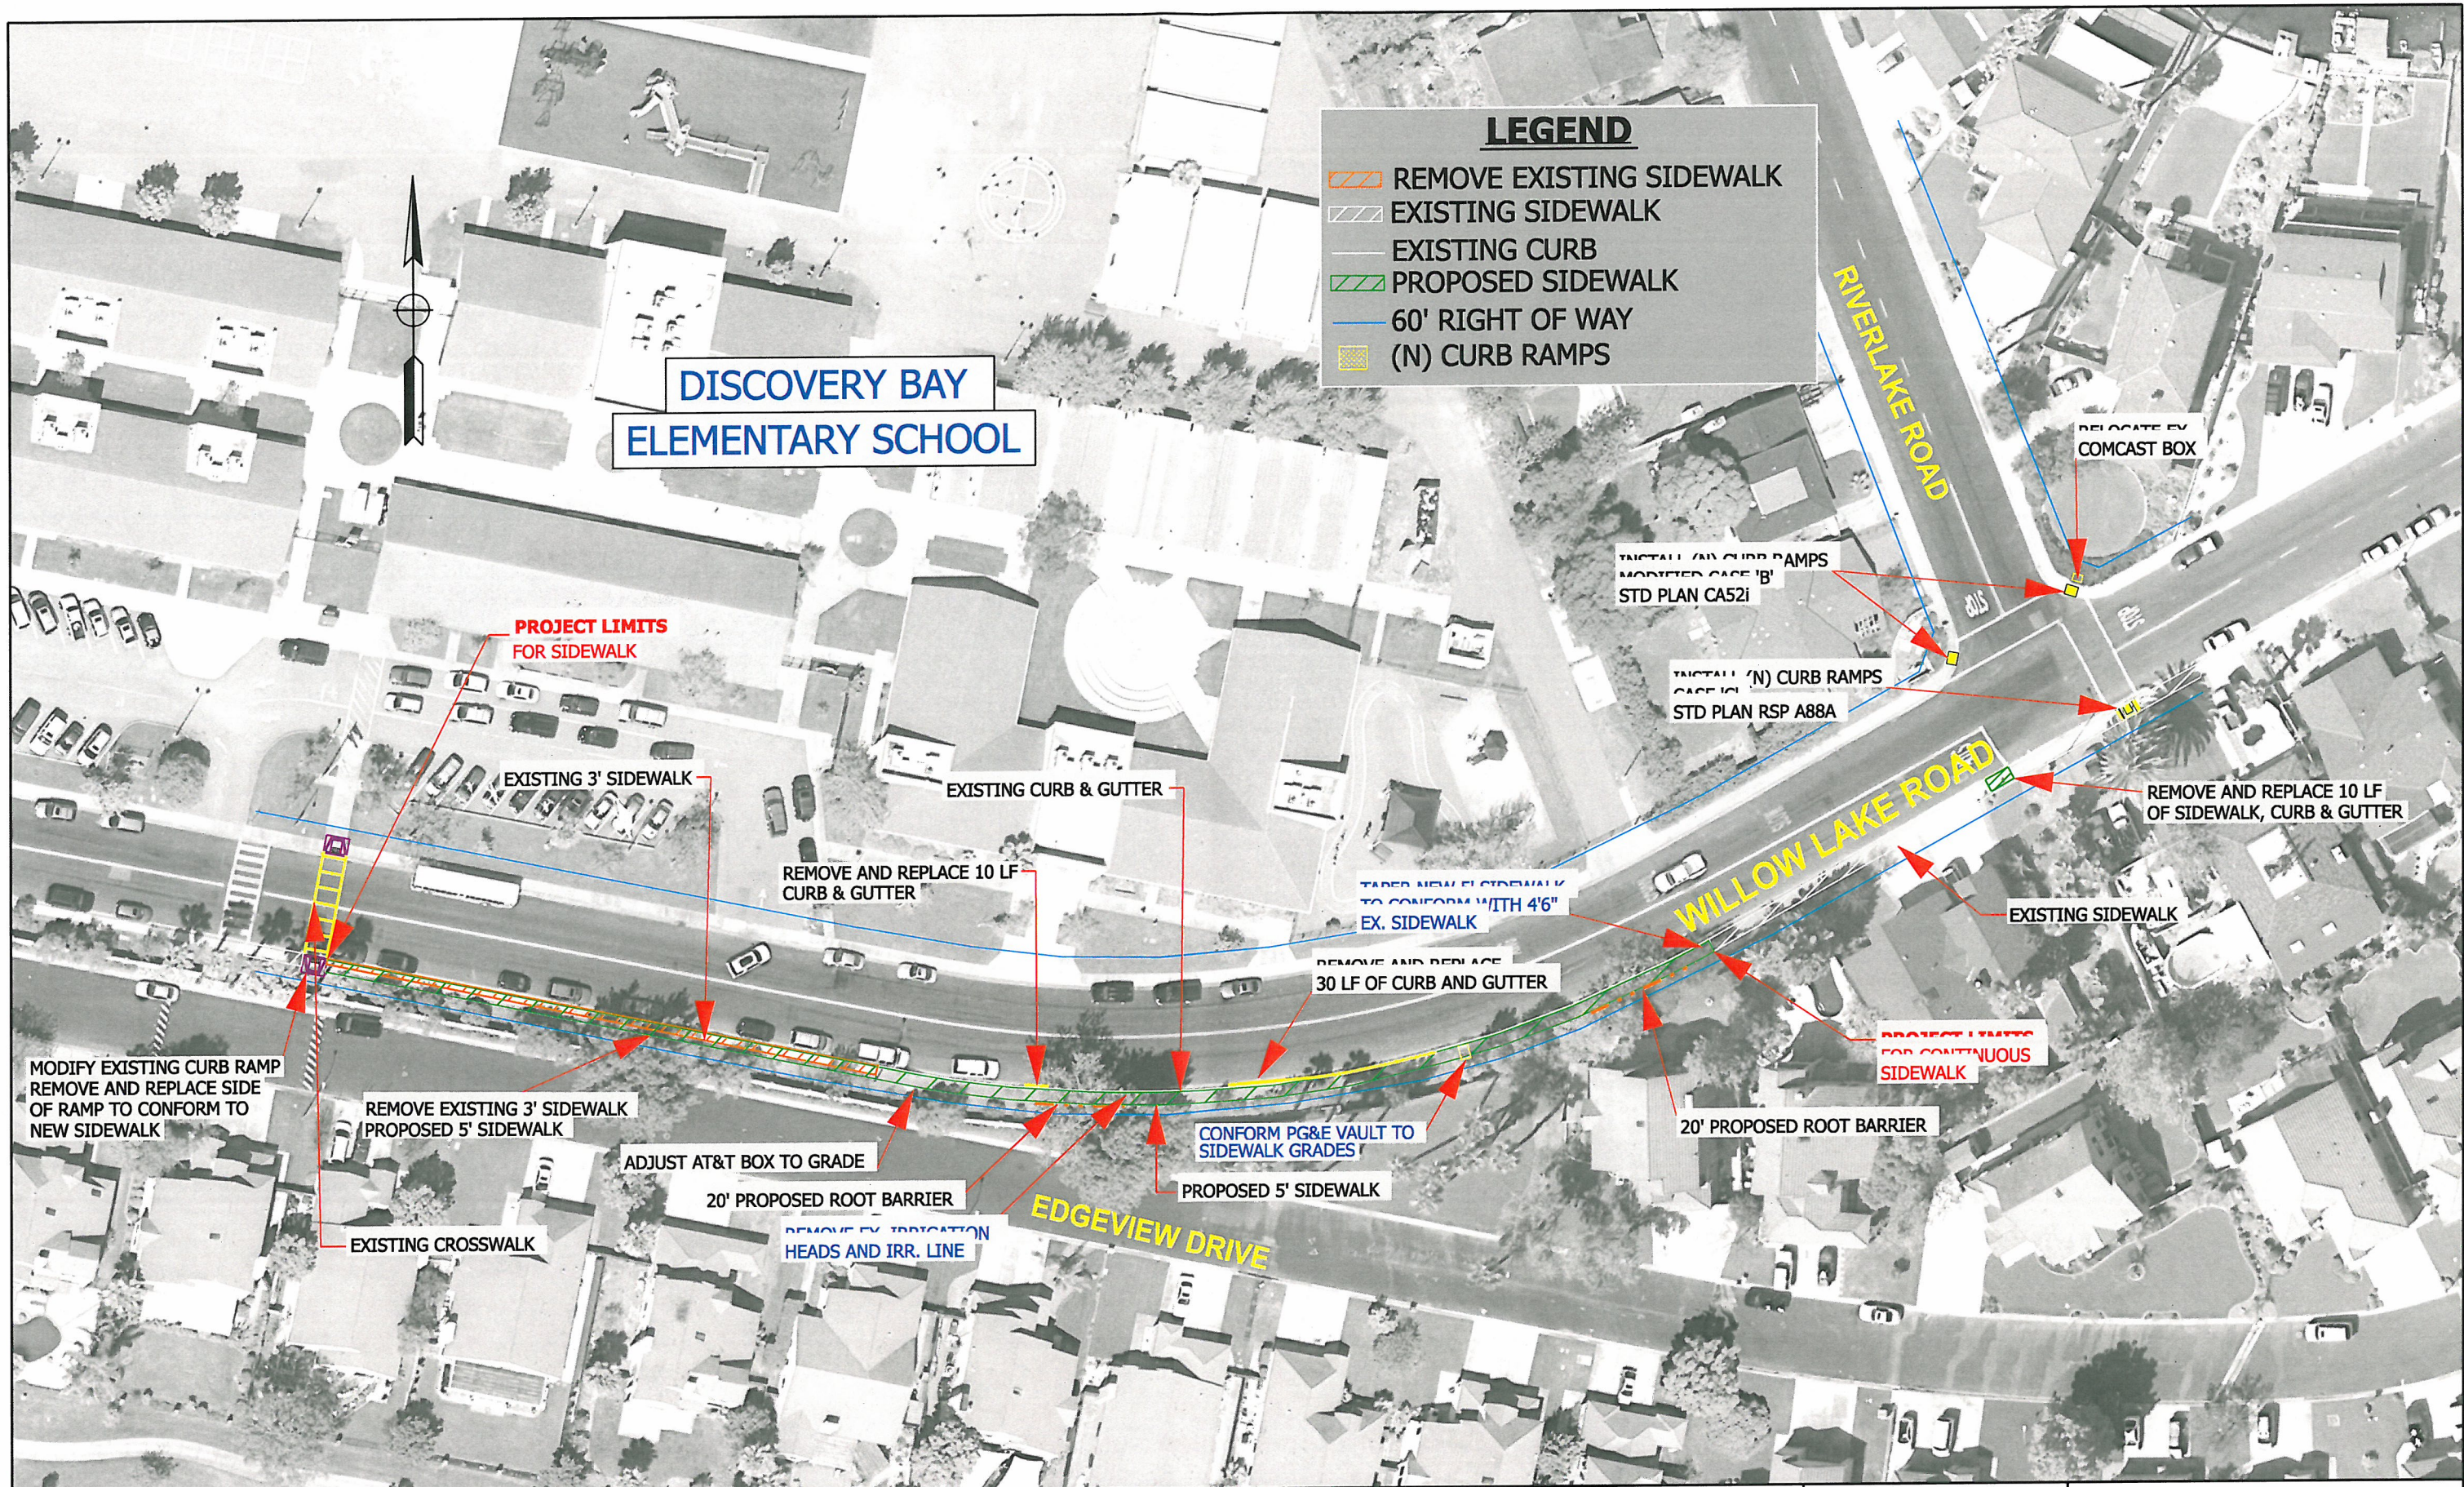

REVISIONS				DES.: <u>R. URBINA</u>		PROJECT ENGINEER	CONTRA COSTA COUNTY PUBLIC WORKS DEPARTMENT 255 GLACIER DRIVE MARTINEZ, CALIFORNIA 94553	CONTRACT NO. <u>0662-6R4119-10</u> DATE ACCEPTED <u>10-25-10</u> RECORD DRAWING RESIDENT ENGINEER REVISIONS BY <u>L. COSTA</u> DATE <u>12-15-10</u>	FOR REDUCED PLANS ORIGINAL SCALE IS IN INCHES			WILLOW LAKE ROAD SIDEWALK GAP CLOSURE PHASE II				
NO.	DESCRIPTION	BY	DATE	DRAWN: <u>L. COSTA</u>					0 1 2 3			DETAILED LAYOUT				
				CHKD.: <u>M. HALLE</u>					BASE MAP	EAST COORD.	NORTH COORD.	FILE NO.	SP-GC-2010		SHEET	2 OF 2
				DATE: <u>11-18-10</u>					N28,N29	1683	512					
				SCALE: <u>1"=30'</u>					PLANS APPROVAL DATE			FILE NAME: <u>dc411910.002</u>			PEN TBL:	
				FLD. BK.												