


RECEIVED
CONTRA COSTA COUNTY
JUN 25 2019
Dept of Conservation & Development


HABITAT FOR HUMANITY
EAST BAY / SILICON VALLEY, INC.
589 PACIFICA AVENUE, BAYPOINT, CA 94565
PACIFICA LANDING

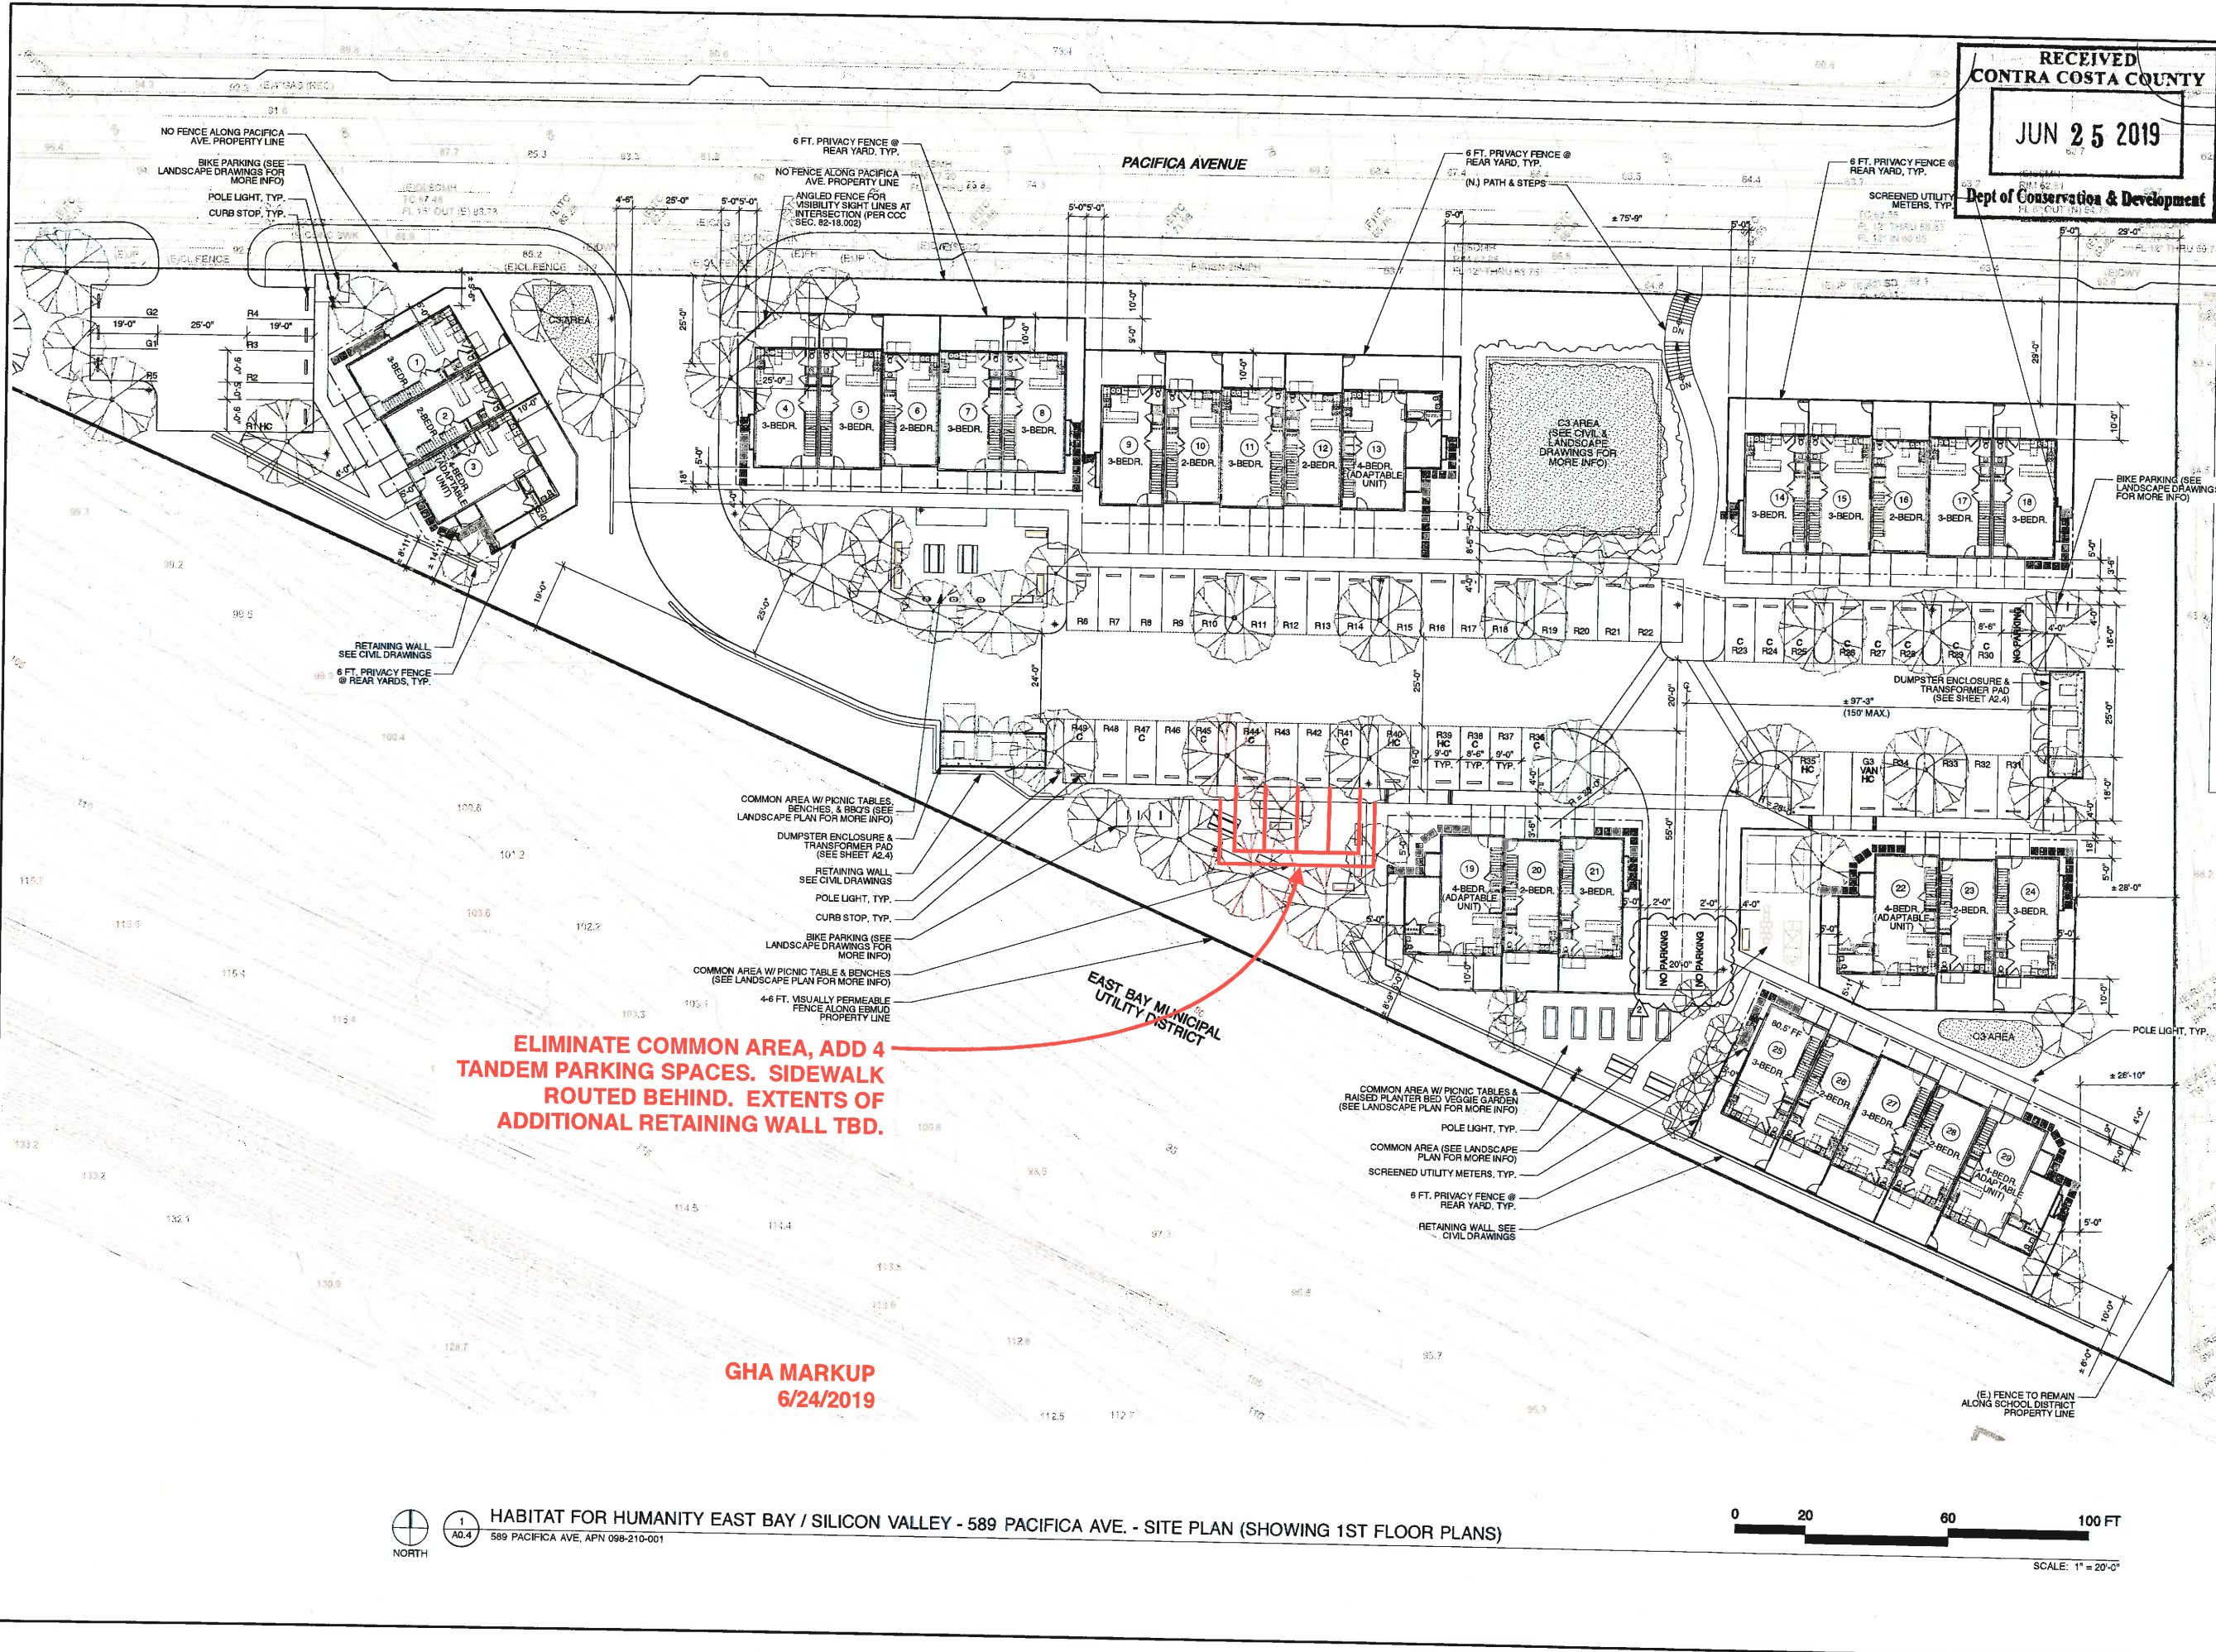

ELIMINATE COMMON AREA, ADD 4 TANDEM PARKING SPACES. SIDEWALK ROUTED BEHIND. EXTENTS OF ADDITIONAL RETAINING WALL TBD.

**GHA MARKUP
6/24/2019**

GHA
GEOFFREY HOLTON & ASSOCIATES
1743 Alcatraz Avenue
Berkeley, CA 94703
tel: 510.863.8797
fax: 510.863.1807
http://www.ghadesign.net

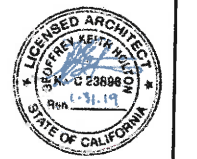

CURRENT
ISSUE DATE
5/21/2018
INITIAL
SUBMITTAL DATE
12/20/17
REVISIONS
PLANNING
RESUBMITTAL
3/13/2018
PLANNING
RESUBMITTAL
5/21/2018



1 HABITAT FOR HUMANITY EAST BAY / SILICON VALLEY - 589 PACIFICA AVE. - SITE PLAN (SHOWING 1ST FLOOR PLANS)
A0.4 589 PACIFICA AVE, APN 098-210-001



SCALE: 1" = 20'-0"

SHEET NO.
A0.4
SITE PLAN